
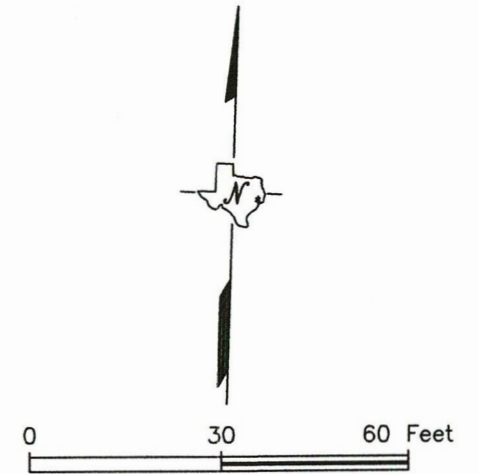


LOCKWOOD DRIVE (100' R/W)
(100' R/W PER CITY OF HOUSTON ORD. NO. 93-377)
(ORIGINALLY 80' R/W PER VOL. 15, PG. 18 H.C.M.R.)

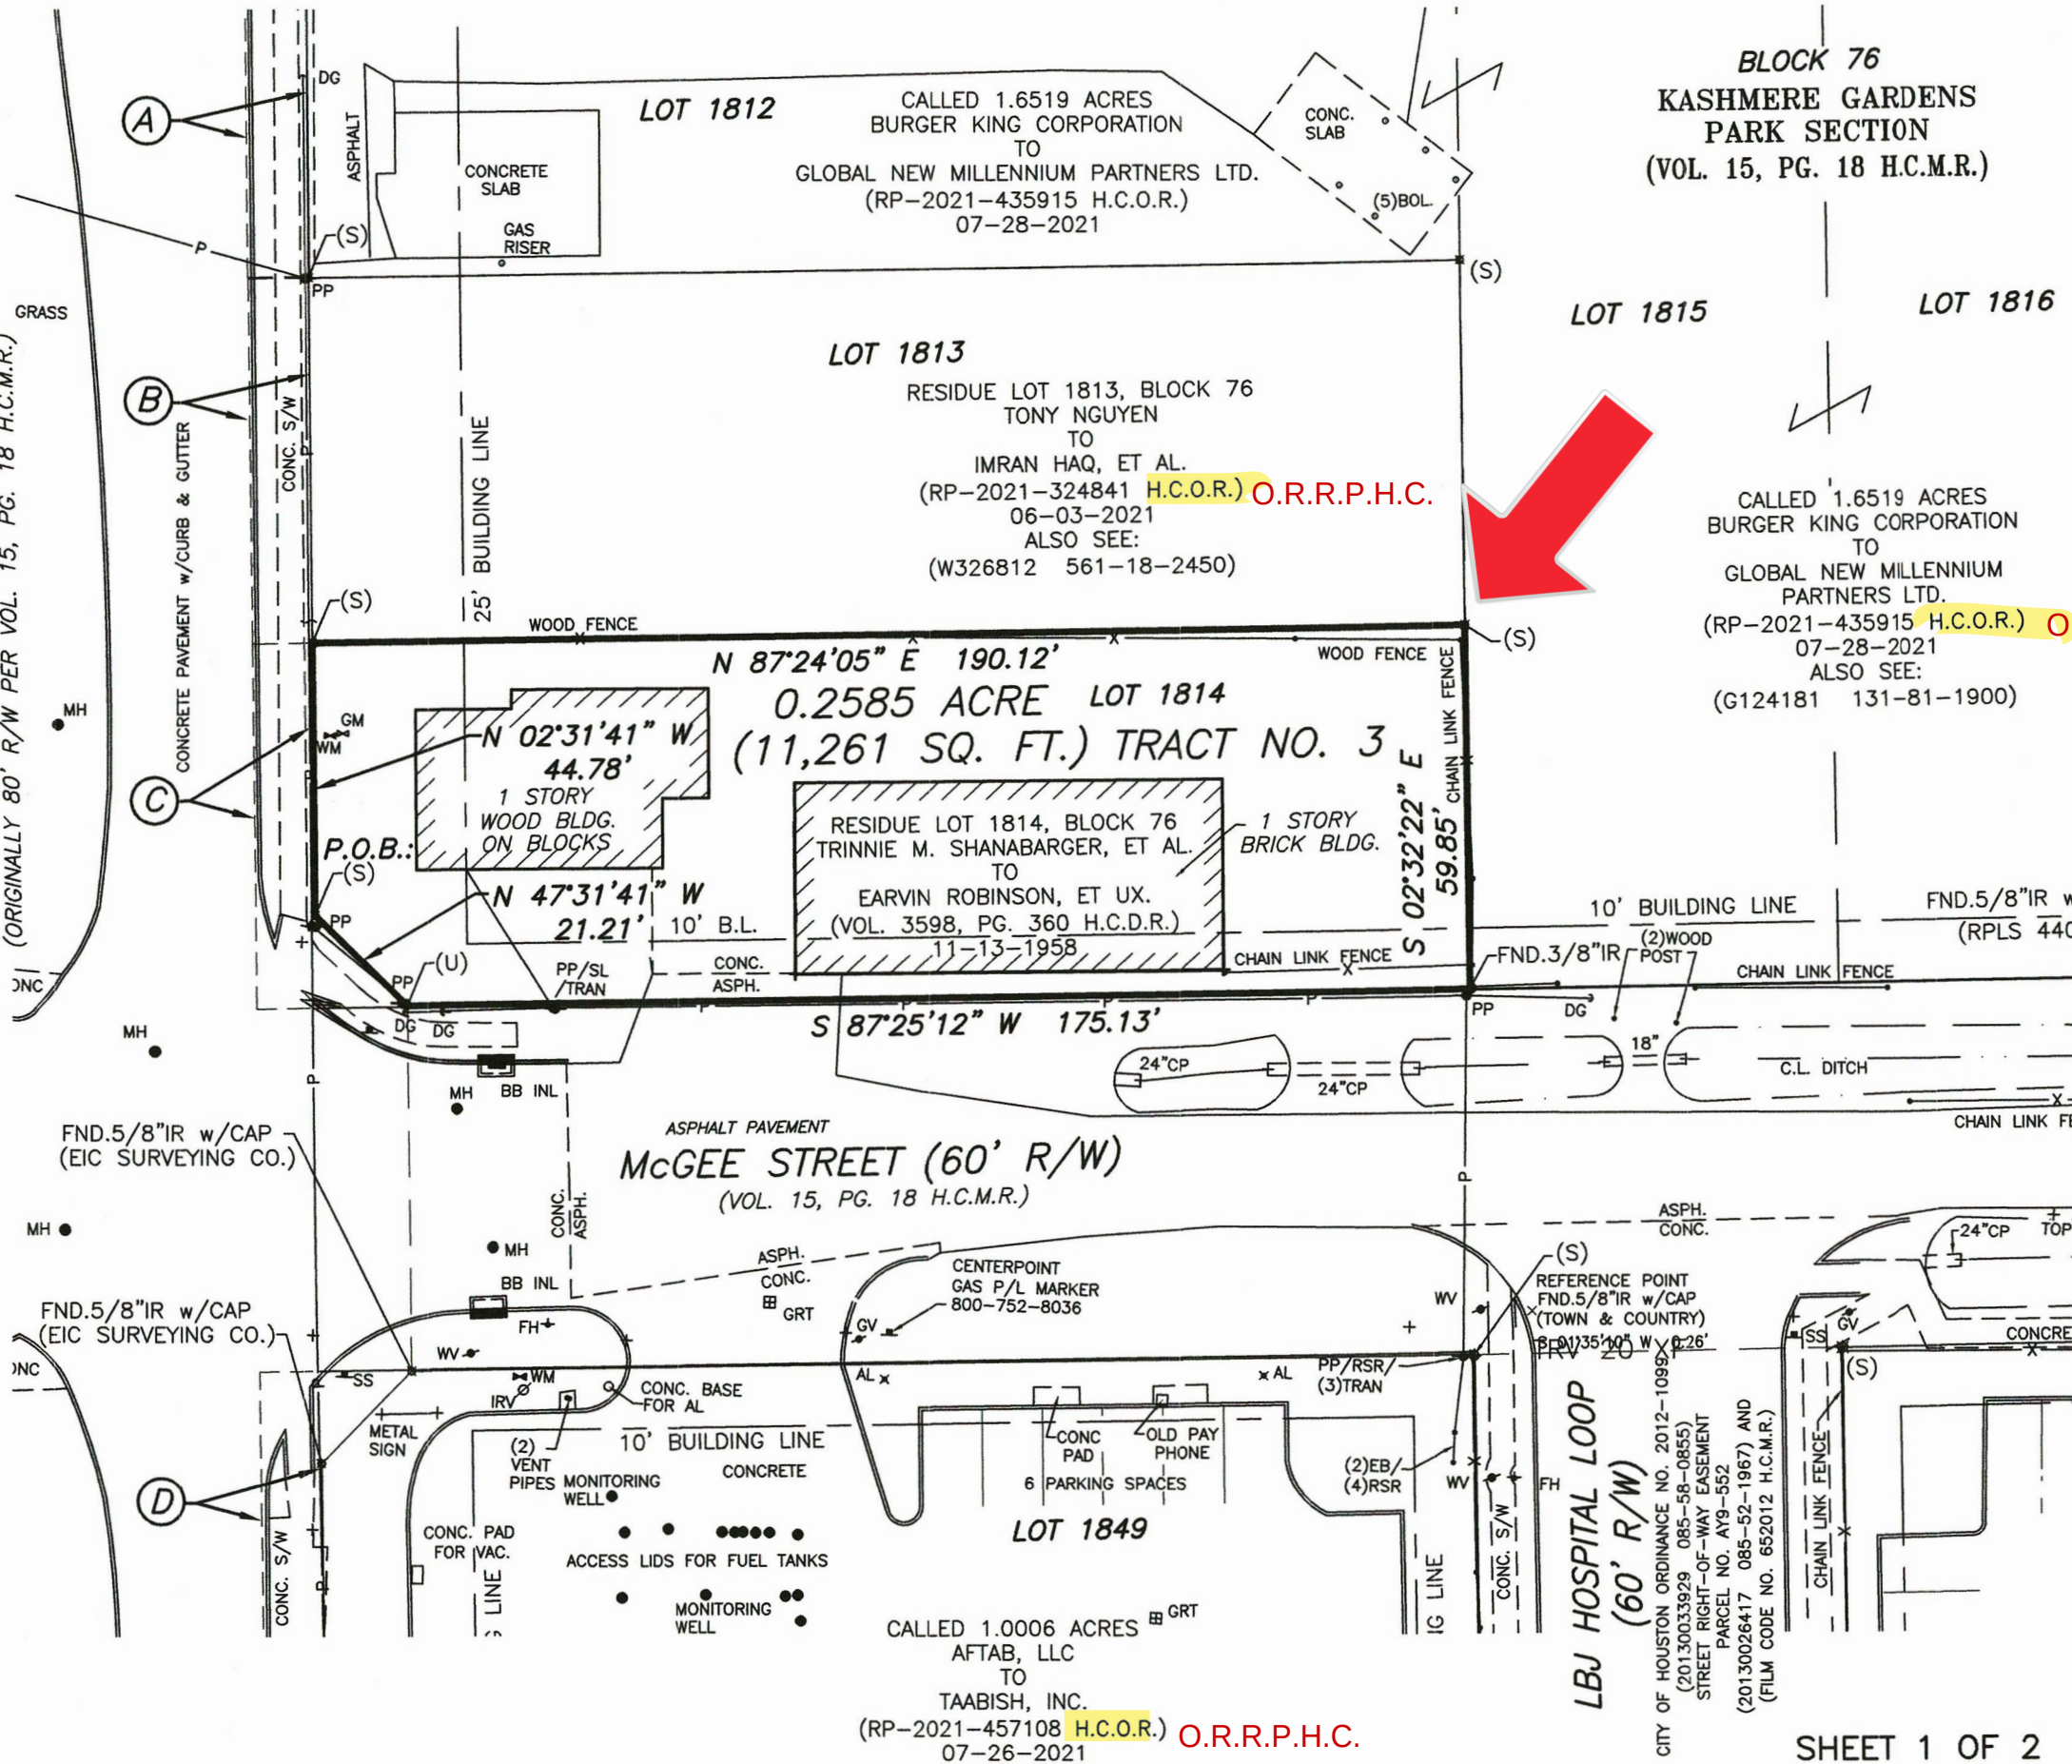

01/20/2022
DATE

MICHAEL A. den UIJL
5698
R.P.L.S. No.

I HEREBY CERTIFY THAT THIS SURVEY WAS MADE ON THE GROUND ON 12-17-2021 AND THAT THIS DRAWING SUBSTANTIALLY COMPLIES WITH THE CURRENT TEXAS SOCIETY OF PROFESSIONAL SURVEYORS STANDARDS AND SPECIFICATIONS FOR A CATEGORY 1A, CONDITION II SURVEY.

THIS CERTIFICATION IS REVOKED AND THE SURVEY NULL AND VOID IF THIS DOCUMENT IS ALTERED IN ANY MANNER, OR DOES NOT BEAR AN ORIGINAL SEAL AND SIGNATURE OF THE SURVEYOR.

Please Add Project Name and UPIN

TRACT NO. 3

C.L. DAVIS & CO. 1500 WINDING WAY
FRIENDSWOOD, TEXAS 77546
281-482-9490
FIRM NO. 10082000

LAND TITLE SURVEY

0.2585 ACRE BEING A
PORTION OF LOT 1814, BLOCK 76
KASHMERE GARDENS PARK SECTION
(VOL. 15, PG. 18 H.C.M.R.)
HOUSTON, HARRIS COUNTY, TEXAS
COUNTY PROJECT NO. ?

DATE: 12-20-2021 SCALE: 1" = 30' JOB NO.: 11-999-2020
DWG. 11-999-2020-BASE

SHEET 1 OF 2